

YANEY STREET

U.S. HWY. 395

MOKLER DESIGN  
P.O. Box 8529  
126 Old Mammoth Road  
Mammoth Lakes, CA 93546  
Phone: 760-924-0800  
Fax: 760-924-0805  
e-mail: pete@moklerdesign.com  
website: moklerdesign.com

CONSULTANTS

JOB NAME AND ADDRESS

COTTONWOOD PLAZA

RL MANAGEMENT  
P.O. BOX 385  
BISHOP, CA. 93514  
(760) 872-4124 PHONE  
(760) 872-1164 FAX

OWNER

9/10/05 INITIAL SITE PLAN

PROJECT NO:

CAD DWG FILE:

DRAWN BY:

CHK'D BY:


COPYRIGHT:

MOKLER DESIGN 2005

SHEET TITLE

COTTONWOOD PLAZA  
SITE PLAN

SHEET 1 OF 1

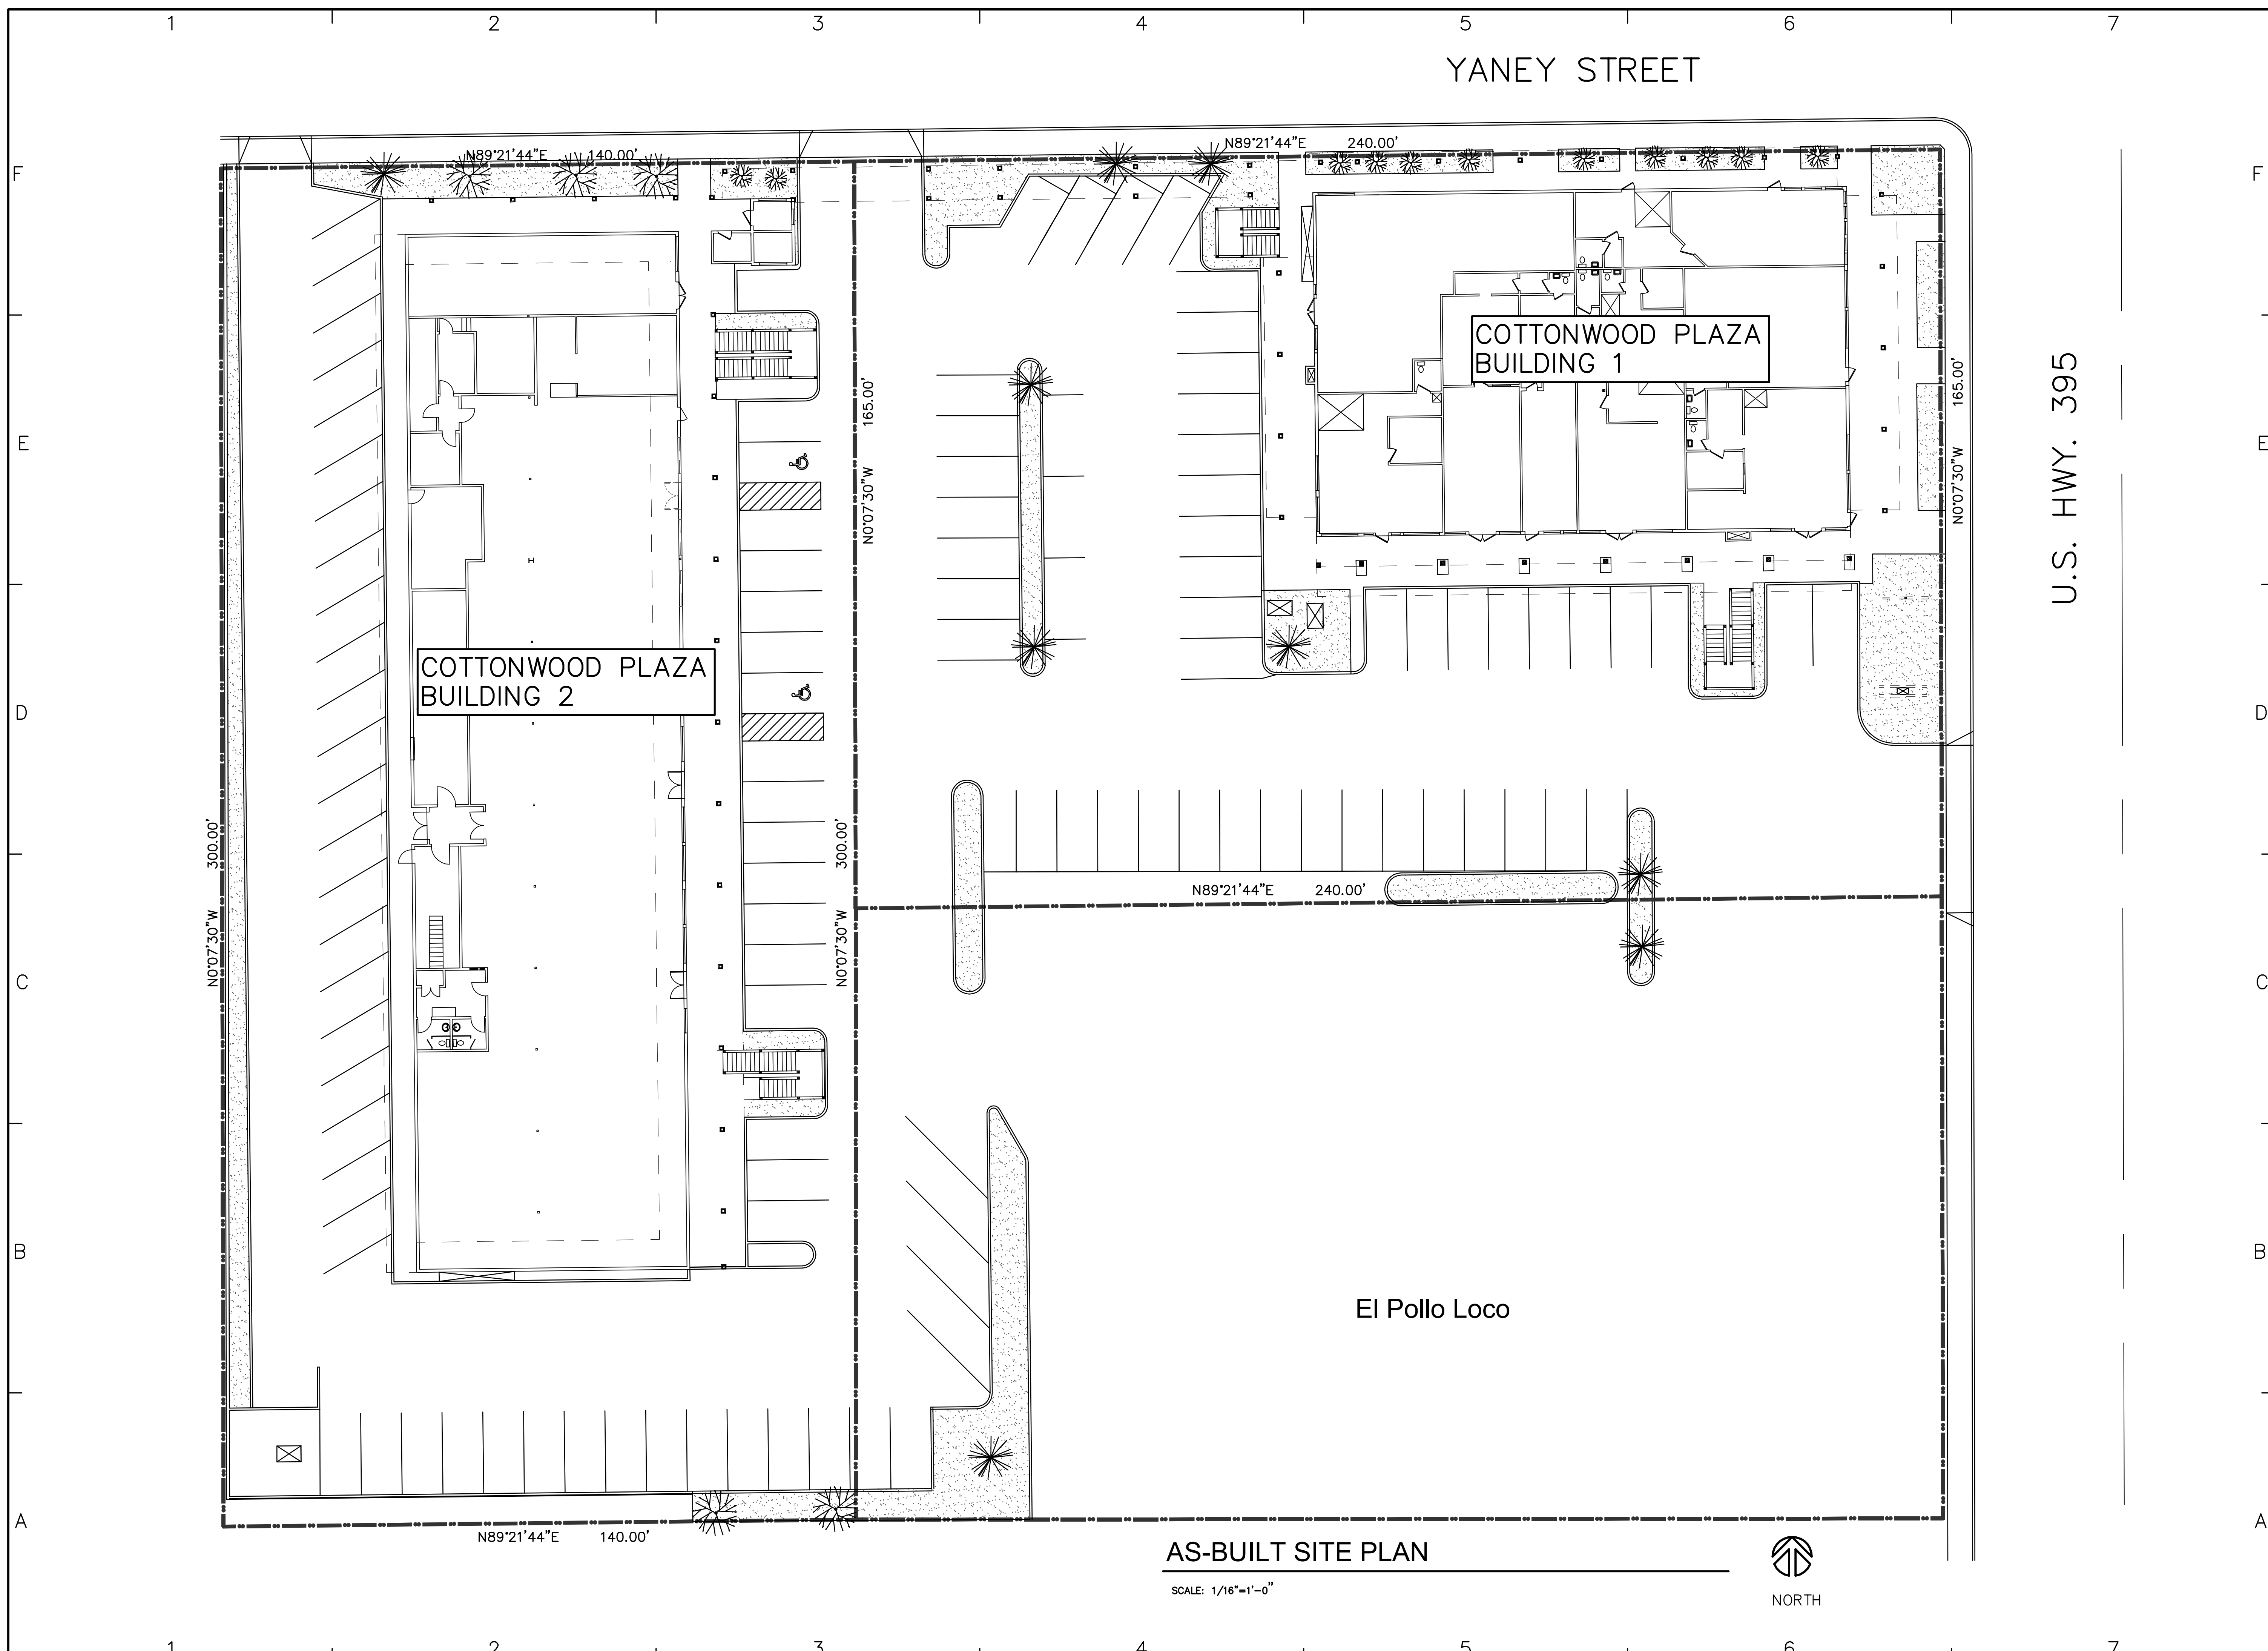


AS-BUILT SITE PLAN

SCALE: 1/16"=1'-0"



NORTH

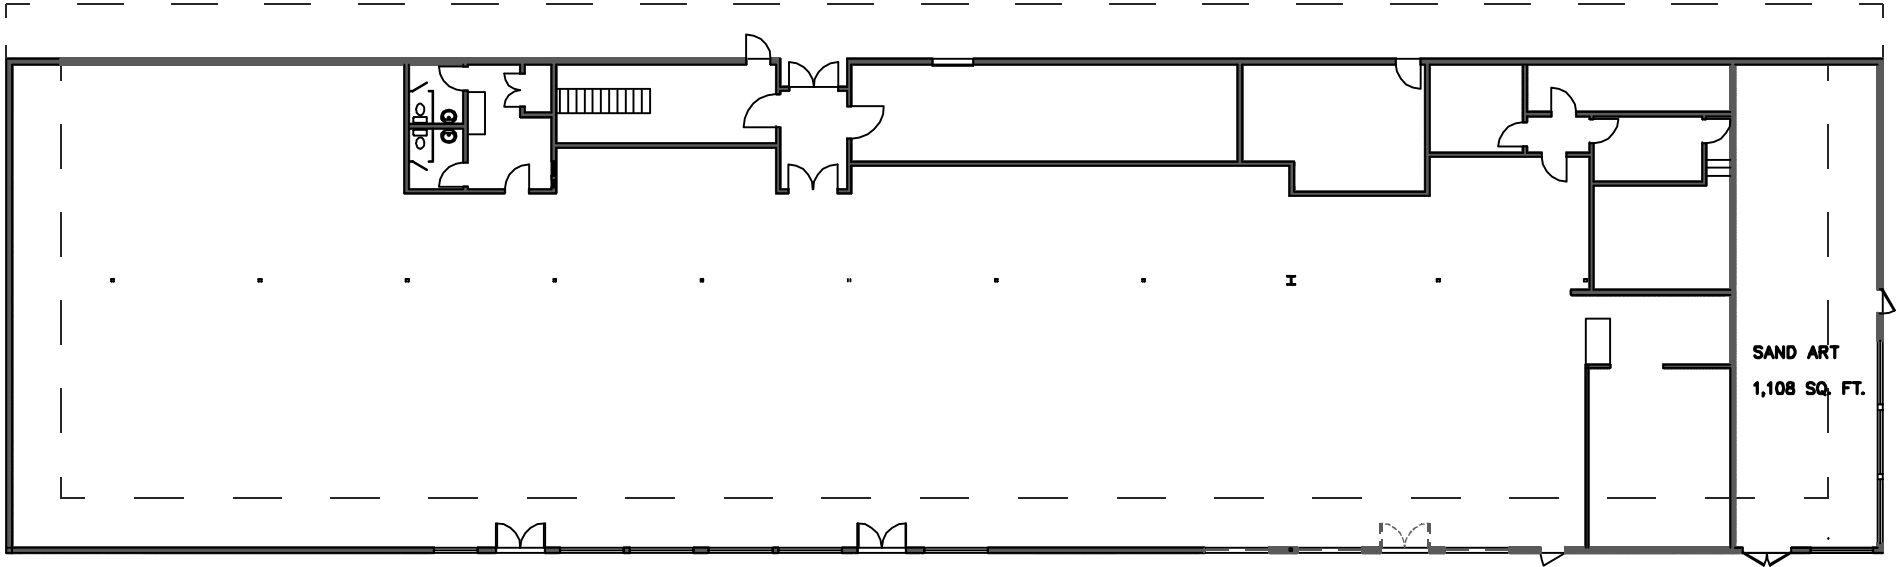

COTTONWOOD PLAZA  
BUILDING 2 – LOWER LEVEL





